



SITE

REV B

Northgate Commerce Center

Client: Northgate Property Group · B1.FL1

Address: 1400 Northgate Blvd

Job number: 24-1188 · GC contact: Marla Ruiz, Hensel Phelps

SUMMARY

Racks	3
Panels	6
Devices	5
Ports	192
Outlets	184
Fault	3
Terminated	27
Tested	156
Empty	6

PORT MAP KEY

07	Fault
08	Terminated
09	Tested
10	Patched
11	Empty

CERTIFICATION

The technician named below certifies that this report accurately describes the panels, ports, terminations and work area locations as installed, for the racks and panels included in this document, as of the issue date. No test result or link performance is certified by this document.

Technician of record	Dane Kowalski
License	LV-00000
Revision	B
Issue date	September 14, 2026

Contents

REV B

SITE	PAGES
Northgate Commerce Center	11 sheets · 23 pages

SECTIONS

Work areas	3–9
Rack elevations	10–12
Panels	13–23

SHEETS

RKA	10	PP01	13	PP05	21
RKB	11	PP02	15	PP06	23
RKC	12	PP03	19	SW01	16
FW01	18	PP04	20		

Work areas

REV B

SITE

SUMMARY

Northgate Commerce Center

184 drops · 9 of 9 rooms cabled · 2 backbone ports

FLOOR FL1

B1.FL1.101 Reception

8 of 8 outlets cabled

OUTLET	PANEL PORT	CABLE	STATUS
B1.FL1.101-A01	B1.FL1.104.PP01-01	Cat6A	Tested
B1.FL1.101-A02	B1.FL1.104.PP01-02	Cat6A	Tested
B1.FL1.101-A03	B1.FL1.104.PP01-03	Cat6A	Tested
B1.FL1.101-A04	B1.FL1.104.PP01-04	Cat6A	Tested
B1.FL1.101-A05	B1.FL1.104.PP01-05	Cat6A	Tested
B1.FL1.101-A06	B1.FL1.104.PP01-06	Cat6A	Tested
B1.FL1.101-A07	B1.FL1.104.PP01-07	Cat6A	Tested
B1.FL1.101-A08	B1.FL1.104.PP01-08	Cat6A	Tested

B1.FL1.102 Open office north

48 of 48 outlets cabled · 2 faults

OUTLET	PANEL PORT	CABLE	STATUS
B1.FL1.102-B01	B1.FL1.104.PP01-09	Cat6A	Tested
B1.FL1.102-B02	B1.FL1.104.PP01-10	Cat6A	Tested
B1.FL1.102-B03	B1.FL1.104.PP01-11	Cat6A	Tested
B1.FL1.102-B04	B1.FL1.104.PP01-12	Cat6A	Tested
B1.FL1.102-B05	B1.FL1.104.PP01-13	Cat6A	Tested
B1.FL1.102-B06	B1.FL1.104.PP01-14	Cat6A	Tested
B1.FL1.102-B07	B1.FL1.104.PP01-15	Cat6A	Tested
B1.FL1.102-B08	B1.FL1.104.PP01-16	Cat6A	Tested
B1.FL1.102-B09	B1.FL1.104.PP01-17	Cat6A	Tested
B1.FL1.102-B10	B1.FL1.104.PP01-18	Cat6A	Tested
B1.FL1.102-B11	B1.FL1.104.PP01-19	Cat6A	Tested
B1.FL1.102-B12	B1.FL1.104.PP01-20	Cat6A	Fault
B1.FL1.102-B13	B1.FL1.104.PP01-21	Cat6A	Tested
B1.FL1.102-B14	B1.FL1.104.PP01-22	Cat6A	Tested
B1.FL1.102-B15	B1.FL1.104.PP01-23	Cat6A	Tested
B1.FL1.102-B16	B1.FL1.104.PP01-24	Cat6A	Tested
B1.FL1.102-B17	B1.FL1.104.PP01-25	Cat6A	Tested
B1.FL1.102-B18	B1.FL1.104.PP01-26	Cat6A	Tested
B1.FL1.102-B19	B1.FL1.104.PP01-27	Cat6A	Tested

Work areas · Floor FL1 · B1.FL1.102 · Open office north (cont.)

REV B

SITE

Northgate Commerce Center

OUTLET	PANEL PORT	CABLE	STATUS
B1.FL1.102-B20	B1.FL1.104.PP01-28	Cat6A	Tested
B1.FL1.102-B21	B1.FL1.104.PP01-29	Cat6A	Tested
B1.FL1.102-B22	B1.FL1.104.PP01-30	Cat6A	Tested
B1.FL1.102-B23	B1.FL1.104.PP01-31	Cat6A	Fault
B1.FL1.102-B24	B1.FL1.104.PP01-32	Cat6A	Tested
B1.FL1.102-B25	B1.FL1.104.PP01-33	Cat6A	Tested
B1.FL1.102-B26	B1.FL1.104.PP01-34	Cat6A	Tested
B1.FL1.102-B27	B1.FL1.104.PP01-35	Cat6A	Tested
B1.FL1.102-B28	B1.FL1.104.PP01-36	Cat6A	Tested
B1.FL1.102-B29	B1.FL1.104.PP01-37	Cat6A	Tested
B1.FL1.102-B30	B1.FL1.104.PP01-38	Cat6A	Tested
B1.FL1.102-B31	B1.FL1.104.PP01-39	Cat6A	Tested
B1.FL1.102-B32	B1.FL1.104.PP01-40	Cat6A	Tested
B1.FL1.102-B33	B1.FL1.104.PP01-41	Cat6A	Terminated
B1.FL1.102-B34	B1.FL1.104.PP01-42	Cat6A	Terminated
B1.FL1.102-B35	B1.FL1.104.PP01-43	Cat6A	Terminated
B1.FL1.102-B36	B1.FL1.104.PP01-44	Cat6A	Terminated
B1.FL1.102-B37	B1.FL1.104.PP01-45	Cat6A	Terminated
B1.FL1.102-B38	B1.FL1.104.PP01-46	Cat6A	Terminated
B1.FL1.102-B39	B1.FL1.104.PP02-01	Cat6A	Tested
B1.FL1.102-B40	B1.FL1.104.PP02-02	Cat6A	Tested
B1.FL1.102-B41	B1.FL1.104.PP02-03	Cat6A	Tested
B1.FL1.102-B42	B1.FL1.104.PP02-04	Cat6A	Tested
B1.FL1.102-B43	B1.FL1.104.PP02-05	Cat6A	Tested
B1.FL1.102-B44	B1.FL1.104.PP02-06	Cat6A	Tested
B1.FL1.102-B45	B1.FL1.104.PP02-07	Cat6A	Tested
B1.FL1.102-B46	B1.FL1.104.PP02-08	Cat6A	Tested
B1.FL1.102-B47	B1.FL1.104.PP02-09	Cat6A	Tested
B1.FL1.102-B48	B1.FL1.104.PP02-10	Cat6A	Tested

B1.FL1.103 Conference A

12 of 12 outlets cabled

OUTLET	PANEL PORT	CABLE	STATUS
B1.FL1.103-C01	B1.FL1.104.PP02-11	Cat6A	Tested
B1.FL1.103-C02	B1.FL1.104.PP02-12	Cat6A	Tested
B1.FL1.103-C03	B1.FL1.104.PP02-13	Cat6A	Tested

Work areas · Floor FL1 · B1.FL1.103 · Conference A (cont.)

REV B

SITE

Northgate Commerce Center

OUTLET	PANEL PORT	CABLE	STATUS
B1.FL1.103-C04	B1.FL1.104.PP02-14	Cat6A	Tested
B1.FL1.103-C05	B1.FL1.104.PP02-15	Cat6A	Tested
B1.FL1.103-C06	B1.FL1.104.PP02-16	Cat6A	Tested
B1.FL1.103-C07	B1.FL1.104.PP02-17	Cat6A	Tested
B1.FL1.103-C08	B1.FL1.104.PP02-18	Cat6A	Tested
B1.FL1.103-C09	B1.FL1.104.PP02-19	Cat6A	Terminated
B1.FL1.103-C10	B1.FL1.104.PP02-20	Cat6A	Terminated
B1.FL1.103-C11	B1.FL1.104.PP02-21	Cat6A	Terminated
B1.FL1.103-C12	B1.FL1.104.PP02-22	Cat6A	Terminated

B1.FL1.104 MDF

4 of 4 outlets cabled

OUTLET	PANEL PORT	CABLE	STATUS
B1.FL1.104-D01	B1.FL1.104.PP04-21	Cat6A	Tested
B1.FL1.104-D02	B1.FL1.104.PP04-22	Cat6A	Tested
B1.FL1.104-D03	B1.FL1.104.PP04-23	Cat6A	Tested
B1.FL1.104-D04	B1.FL1.104.PP04-24	Cat6A	Tested

B1.FL1.105 Warehouse office

24 of 24 outlets cabled

OUTLET	PANEL PORT	CABLE	STATUS
B1.FL1.105-E01	B1.FL1.104.PP03-01	Cat6A	Tested
B1.FL1.105-E02	B1.FL1.104.PP03-02	Cat6A	Tested
B1.FL1.105-E03	B1.FL1.104.PP03-03	Cat6A	Tested
B1.FL1.105-E04	B1.FL1.104.PP03-04	Cat6A	Tested
B1.FL1.105-E05	B1.FL1.104.PP03-05	Cat6A	Tested
B1.FL1.105-E06	B1.FL1.104.PP03-06	Cat6A	Tested
B1.FL1.105-E07	B1.FL1.104.PP03-07	Cat6A	Tested
B1.FL1.105-E08	B1.FL1.104.PP03-08	Cat6A	Tested
B1.FL1.105-E09	B1.FL1.104.PP03-09	Cat6A	Tested
B1.FL1.105-E10	B1.FL1.104.PP03-10	Cat6A	Tested
B1.FL1.105-E11	B1.FL1.104.PP03-11	Cat6A	Tested
B1.FL1.105-E12	B1.FL1.104.PP03-12	Cat6A	Tested
B1.FL1.105-E13	B1.FL1.104.PP03-13	Cat6A	Tested
B1.FL1.105-E14	B1.FL1.104.PP03-14	Cat6A	Tested
B1.FL1.105-E15	B1.FL1.104.PP03-15	Cat6A	Tested
B1.FL1.105-E16	B1.FL1.104.PP03-16	Cat6A	Tested

Work areas · Floor FL1 · B1.FL1.105 · Warehouse office (cont.)

REV B

SITE

Northgate Commerce Center

OUTLET	PANEL PORT	CABLE	STATUS
B1.FL1.105-E17	B1.FL1.104.PP03-17	Cat6A	Tested
B1.FL1.105-E18	B1.FL1.104.PP03-18	Cat6A	Tested
B1.FL1.105-E19	B1.FL1.104.PP03-19	Cat6A	Tested
B1.FL1.105-E20	B1.FL1.104.PP03-20	Cat6A	Tested
B1.FL1.105-E21	B1.FL1.104.PP03-21	Cat6A	Tested
B1.FL1.105-E22	B1.FL1.104.PP03-22	Cat6A	Tested
B1.FL1.105-E23	B1.FL1.104.PP03-23	Cat6A	Tested
B1.FL1.105-E24	B1.FL1.104.PP03-24	Cat6A	Tested

B1.FL1.106 Break room

20 of 20 outlets cabled

OUTLET	PANEL PORT	CABLE	STATUS
B1.FL1.106-F01	B1.FL1.104.PP04-01	Cat6A	Tested
B1.FL1.106-F02	B1.FL1.104.PP04-02	Cat6A	Tested
B1.FL1.106-F03	B1.FL1.104.PP04-03	Cat6A	Tested
B1.FL1.106-F04	B1.FL1.104.PP04-04	Cat6A	Tested
B1.FL1.106-F05	B1.FL1.104.PP04-05	Cat6A	Tested
B1.FL1.106-F06	B1.FL1.104.PP04-06	Cat6A	Tested
B1.FL1.106-F07	B1.FL1.104.PP04-07	Cat6A	Tested
B1.FL1.106-F08	B1.FL1.104.PP04-08	Cat6A	Tested
B1.FL1.106-F09	B1.FL1.104.PP04-09	Cat6A	Tested
B1.FL1.106-F10	B1.FL1.104.PP04-10	Cat6A	Tested
B1.FL1.106-F11	B1.FL1.104.PP04-11	Cat6A	Tested
B1.FL1.106-F12	B1.FL1.104.PP04-12	Cat6A	Tested
B1.FL1.106-F13	B1.FL1.104.PP04-13	Cat6A	Tested
B1.FL1.106-F14	B1.FL1.104.PP04-14	Cat6A	Tested
B1.FL1.106-F15	B1.FL1.104.PP04-15	Cat6A	Tested
B1.FL1.106-F16	B1.FL1.104.PP04-16	Cat6A	Tested
B1.FL1.106-F17	B1.FL1.104.PP04-17	Cat6A	Terminated
B1.FL1.106-F18	B1.FL1.104.PP04-18	Cat6A	Terminated
B1.FL1.106-F19	B1.FL1.104.PP04-19	Cat6A	Terminated
B1.FL1.106-F20	B1.FL1.104.PP04-20	Cat6A	Terminated

Work areas

REV B

SITE

Northgate Commerce Center

FLOOR FL2

B1.FL2.201 Open office south

44 of 44 outlets cabled · 1 fault

OUTLET	PANEL PORT	CABLE	STATUS
B1.FL2.201-G01	B1.FL2.204.PP05-01	Cat6A	Tested
B1.FL2.201-G02	B1.FL2.204.PP05-02	Cat6A	Tested
B1.FL2.201-G03	B1.FL2.204.PP05-03	Cat6A	Tested
B1.FL2.201-G04	B1.FL2.204.PP05-04	Cat6A	Tested
B1.FL2.201-G05	B1.FL2.204.PP05-05	Cat6A	Tested
B1.FL2.201-G06	B1.FL2.204.PP05-06	Cat6A	Tested
B1.FL2.201-G07	B1.FL2.204.PP05-07	Cat6A	Tested
B1.FL2.201-G08	B1.FL2.204.PP05-08	Cat6A	Tested
B1.FL2.201-G09	B1.FL2.204.PP05-09	Cat6A	Tested
B1.FL2.201-G10	B1.FL2.204.PP05-10	Cat6A	Tested
B1.FL2.201-G11	B1.FL2.204.PP05-11	Cat6A	Tested
B1.FL2.201-G12	B1.FL2.204.PP05-12	Cat6A	Tested
B1.FL2.201-G13	B1.FL2.204.PP05-13	Cat6A	Tested
B1.FL2.201-G14	B1.FL2.204.PP05-14	Cat6A	Tested
B1.FL2.201-G15	B1.FL2.204.PP05-15	Cat6A	Tested
B1.FL2.201-G16	B1.FL2.204.PP05-16	Cat6A	Tested
B1.FL2.201-G17	B1.FL2.204.PP05-17	Cat6A	Tested
B1.FL2.201-G18	B1.FL2.204.PP05-18	Cat6A	Tested
B1.FL2.201-G19	B1.FL2.204.PP05-19	Cat6A	Tested
B1.FL2.201-G20	B1.FL2.204.PP05-20	Cat6A	Tested
B1.FL2.201-G21	B1.FL2.204.PP05-21	Cat6A	Tested
B1.FL2.201-G22	B1.FL2.204.PP05-22	Cat6A	Tested
B1.FL2.201-G23	B1.FL2.204.PP05-23	Cat6A	Tested
B1.FL2.201-G24	B1.FL2.204.PP05-24	Cat6A	Tested
B1.FL2.201-G25	B1.FL2.204.PP05-25	Cat6A	Tested
B1.FL2.201-G26	B1.FL2.204.PP05-26	Cat6A	Tested
B1.FL2.201-G27	B1.FL2.204.PP05-27	Cat6A	Tested
B1.FL2.201-G28	B1.FL2.204.PP05-28	Cat6A	Tested
B1.FL2.201-G29	B1.FL2.204.PP05-29	Cat6A	Tested
B1.FL2.201-G30	B1.FL2.204.PP05-30	Cat6A	Tested
B1.FL2.201-G31	B1.FL2.204.PP05-31	Cat6A	Terminated

Work areas · Floor FL2 · B1.FL2.201 · Open office south (cont.)

REV B

SITE

Northgate Commerce Center

OUTLET	PANEL PORT	CABLE	STATUS
B1.FL2.201-G32	B1.FL2.204.PP05-32	Cat6A	Terminated
B1.FL2.201-G33	B1.FL2.204.PP05-33	Cat6A	Terminated
B1.FL2.201-G34	B1.FL2.204.PP05-34	Cat6A	Terminated
B1.FL2.201-G35	B1.FL2.204.PP05-35	Cat6A	Terminated
B1.FL2.201-G36	B1.FL2.204.PP05-36	Cat6A	Terminated
B1.FL2.201-G37	B1.FL2.204.PP05-37	Cat6A	Terminated
B1.FL2.201-G38	B1.FL2.204.PP05-38	Cat6A	Terminated
B1.FL2.201-G39	B1.FL2.204.PP05-39	Cat6A	Terminated
B1.FL2.201-G40	B1.FL2.204.PP05-40	Cat6A	Fault
B1.FL2.201-G41	B1.FL2.204.PP05-41	Cat6A	Terminated
B1.FL2.201-G42	B1.FL2.204.PP05-42	Cat6A	Terminated
B1.FL2.201-G43	B1.FL2.204.PP05-43	Cat6A	Terminated
B1.FL2.201-G44	B1.FL2.204.PP05-44	Cat6A	Terminated

B1.FL2.202 Training room

20 of 20 outlets cabled

OUTLET	PANEL PORT	CABLE	STATUS
B1.FL2.202-J01	B1.FL2.204.PP06-01	Cat6A	Tested
B1.FL2.202-J02	B1.FL2.204.PP06-02	Cat6A	Tested
B1.FL2.202-J03	B1.FL2.204.PP06-03	Cat6A	Tested
B1.FL2.202-J04	B1.FL2.204.PP06-04	Cat6A	Tested
B1.FL2.202-J05	B1.FL2.204.PP06-05	Cat6A	Tested
B1.FL2.202-J06	B1.FL2.204.PP06-06	Cat6A	Tested
B1.FL2.202-J07	B1.FL2.204.PP06-07	Cat6A	Tested
B1.FL2.202-J08	B1.FL2.204.PP06-08	Cat6A	Tested
B1.FL2.202-J09	B1.FL2.204.PP06-09	Cat6A	Tested
B1.FL2.202-J10	B1.FL2.204.PP06-10	Cat6A	Tested
B1.FL2.202-J11	B1.FL2.204.PP06-11	Cat6A	Tested
B1.FL2.202-J12	B1.FL2.204.PP06-12	Cat6A	Tested
B1.FL2.202-J13	B1.FL2.204.PP06-13	Cat6A	Tested
B1.FL2.202-J14	B1.FL2.204.PP06-14	Cat6A	Tested
B1.FL2.202-J15	B1.FL2.204.PP06-15	Cat6A	Tested
B1.FL2.202-J16	B1.FL2.204.PP06-16	Cat6A	Tested
B1.FL2.202-J17	B1.FL2.204.PP06-17	Cat6A	Tested
B1.FL2.202-J18	B1.FL2.204.PP06-18	Cat6A	Tested

Work areas · Floor FL2 · B1.FL2.202 · Training room (cont.)

REV B

SITE

Northgate Commerce Center

OUTLET	PANEL PORT	CABLE	STATUS
B1.FL2.202-J19	B1.FL2.204.PP06-19	Cat6A	Tested
B1.FL2.202-J20	B1.FL2.204.PP06-20	Cat6A	Tested

B1.FL2.204 IDF 2

4 of 4 outlets cabled

OUTLET	PANEL PORT	CABLE	STATUS
B1.FL2.204-H01	B1.FL2.204.PP06-21	Cat6A	Tested
B1.FL2.204-H02	B1.FL2.204.PP06-22	Cat6A	Tested
B1.FL2.204-H03	B1.FL2.204.PP06-23	Cat6A	Tested
B1.FL2.204-H04	B1.FL2.204.PP06-24	Cat6A	Tested


BACKBONE

Panel-to-panel trunks Terminates in no work area

2 ports

FAR END	PANEL PORT	CABLE	STATUS
B1.FL2.204.PP05-47	B1.FL1.104.PP01-47	Cat6A	Tested
B1.FL2.204.PP05-48	B1.FL1.104.PP01-48	Cat6A	Tested

SITE	ROOM	RACK ID	SIZE	CONTENTS
Northgate Commerce Center	104	B1.FL1.104.RKA	42U · 9U used	2 panels · 4 devices · 1 accessory

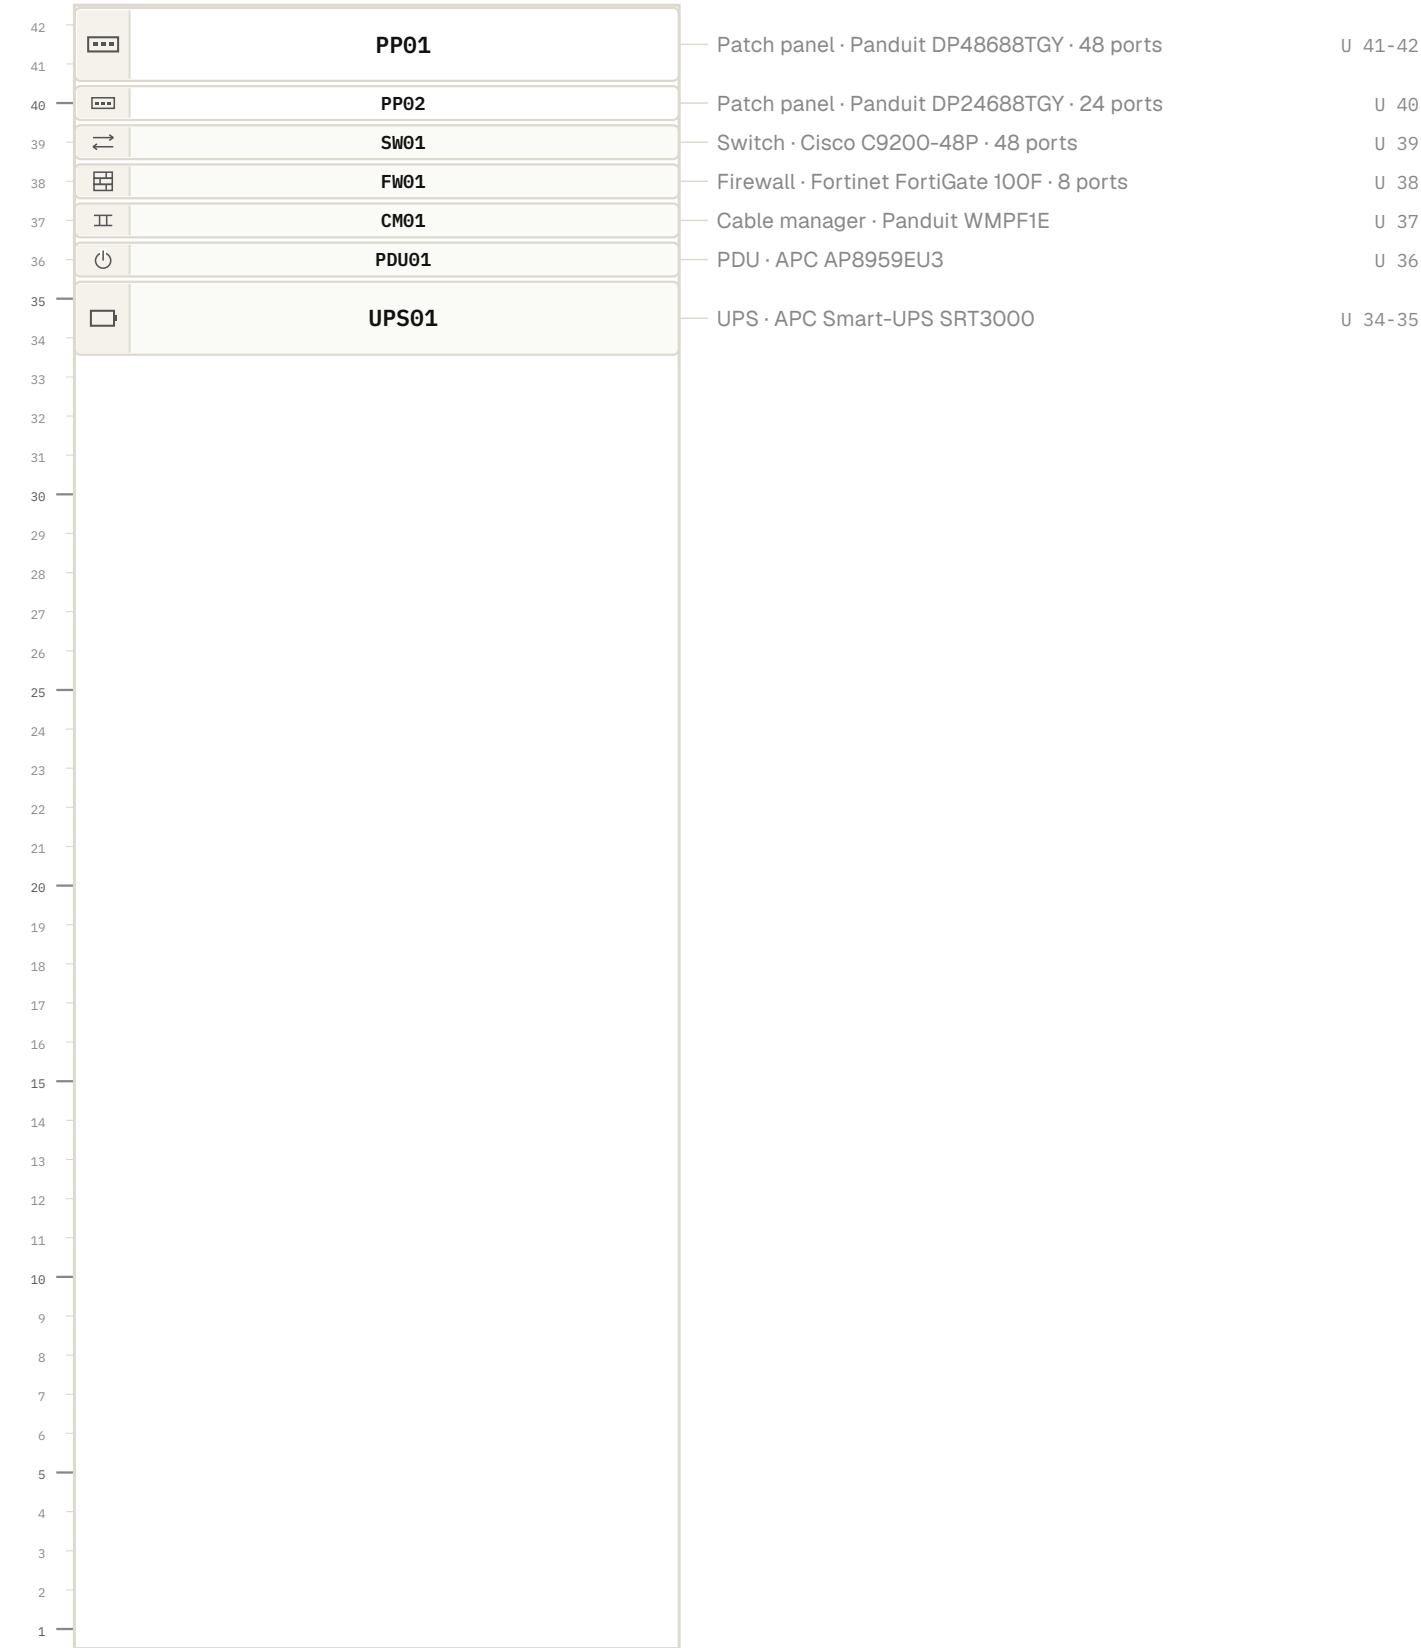

SITE	ROOM	RACK ID	SIZE	CONTENTS
Northgate Commerce Center	104	B1.FL1.104.RKB	42U · 2U used	2 panels

42	PP03	Patch panel · Leviton 49255-H24 · 24 ports	U 42
41	PP04	Patch panel · Leviton 49255-H24 · 24 ports	U 41
40			
39			
SITE	ROOM	RACK ID	SIZE	CONTENTS
Northgate Commerce Center	204	B1.FL2.204.RKC	24U · 3U used	2 panels



PP01

REV B

SITE	RACK	MAKE	MODEL	PORTS	ID
Northgate Commerce Center	B1.FL1.104.RKA	Panduit	DP48688TGY	48 · 40 tested · 6 terminated · 2 faults	B1.FL1.104.PP01

01	02	03	04	05	06	07	08	09	10	11	12	13	14	15	16	17	18	19	20	21	22	23	24
25	26	27	28	29	30	31	32	33	34	35	36	37	38	39	40	41	42	43	44	45	46	47	48

PORT	DESTINATION	CABLE	FUNCTION	STATUS
01	B1.FL1.101-A01	Cat6A	Horizontal	Tested
02	B1.FL1.101-A02	Cat6A	Horizontal	Tested
03	B1.FL1.101-A03	Cat6A	Horizontal	Tested
04	B1.FL1.101-A04	Cat6A	Horizontal	Tested
05	B1.FL1.101-A05	Cat6A	Horizontal	Tested
06	B1.FL1.101-A06	Cat6A	Horizontal	Tested
07	B1.FL1.101-A07	Cat6A	Horizontal	Tested
08	B1.FL1.101-A08	Cat6A	Horizontal	Tested
09	B1.FL1.102-B01	Cat6A	Horizontal	Tested
10	B1.FL1.102-B02	Cat6A	Horizontal	Tested
11	B1.FL1.102-B03	Cat6A	Horizontal	Tested
12	B1.FL1.102-B04	Cat6A	Horizontal	Tested
13	B1.FL1.102-B05	Cat6A	Horizontal	Tested
14	B1.FL1.102-B06	Cat6A	Horizontal	Tested
15	B1.FL1.102-B07	Cat6A	Horizontal	Tested
16	B1.FL1.102-B08	Cat6A	Horizontal	Tested
17	B1.FL1.102-B09	Cat6A	Horizontal	Tested
18	B1.FL1.102-B10	Cat6A	Horizontal	Tested
19	B1.FL1.102-B11	Cat6A	Horizontal	Tested
20	B1.FL1.102-B12	Cat6A	Horizontal	Fault
21	B1.FL1.102-B13	Cat6A	Horizontal	Tested
22	B1.FL1.102-B14	Cat6A	Horizontal	Tested
23	B1.FL1.102-B15	Cat6A	Horizontal	Tested
24	B1.FL1.102-B16	Cat6A	Horizontal	Tested
25	B1.FL1.102-B17	Cat6A	Horizontal	Tested
26	B1.FL1.102-B18	Cat6A	Horizontal	Tested
27	B1.FL1.102-B19	Cat6A	Horizontal	Tested
28	B1.FL1.102-B20	Cat6A	Horizontal	Tested
29	B1.FL1.102-B21	Cat6A	Horizontal	Tested
30	B1.FL1.102-B22	Cat6A	Horizontal	Tested

PP01 (cont.)

REV B

SITE

Northgate Commerce Center

RACK

B1.FL1.104.RKA

PORT	DESTINATION	CABLE	FUNCTION	STATUS
31	B1.FL1.102-B23	Cat6A	Horizontal	Fault
32	B1.FL1.102-B24	Cat6A	Horizontal	Tested
33	B1.FL1.102-B25	Cat6A	Horizontal	Tested
34	B1.FL1.102-B26	Cat6A	Horizontal	Tested
35	B1.FL1.102-B27	Cat6A	Horizontal	Tested
36	B1.FL1.102-B28	Cat6A	Horizontal	Tested
37	B1.FL1.102-B29	Cat6A	Horizontal	Tested
38	B1.FL1.102-B30	Cat6A	Horizontal	Tested
39	B1.FL1.102-B31	Cat6A	Horizontal	Tested
40	B1.FL1.102-B32	Cat6A	Horizontal	Tested
41	B1.FL1.102-B33	Cat6A	Horizontal	Terminated
42	B1.FL1.102-B34	Cat6A	Horizontal	Terminated
43	B1.FL1.102-B35	Cat6A	Horizontal	Terminated
44	B1.FL1.102-B36	Cat6A	Horizontal	Terminated
45	B1.FL1.102-B37	Cat6A	Horizontal	Terminated
46	B1.FL1.102-B38	Cat6A	Horizontal	Terminated
47	B1.FL2.204.PP05-47	Cat6A	1st backbone	Tested
48	B1.FL2.204.PP05-48	Cat6A	1st backbone	Tested

PP02

REV B

SITE	RACK	MAKE	MODEL	PORTS	ID
Northgate Commerce Center	B1.FL1.104.RKA	Panduit	DP24688TGY	24 · 18 tested · 4 terminated · 2 empty	B1.FL1.104.PP02

01	02	03	04	05	06	07	08	09	10	11	12	13	14	15	16	17	18	19	20	21	22	23	24
----	----	----	----	----	----	----	----	----	----	----	----	----	----	----	----	----	----	----	----	----	----	----	----

PORT	DESTINATION	CABLE	FUNCTION	STATUS
01	B1.FL1.102-B39	Cat6A	Horizontal	Tested
02	B1.FL1.102-B40	Cat6A	Horizontal	Tested
03	B1.FL1.102-B41	Cat6A	Horizontal	Tested
04	B1.FL1.102-B42	Cat6A	Horizontal	Tested
05	B1.FL1.102-B43	Cat6A	Horizontal	Tested
06	B1.FL1.102-B44	Cat6A	Horizontal	Tested
07	B1.FL1.102-B45	Cat6A	Horizontal	Tested
08	B1.FL1.102-B46	Cat6A	Horizontal	Tested
09	B1.FL1.102-B47	Cat6A	Horizontal	Tested
10	B1.FL1.102-B48	Cat6A	Horizontal	Tested
11	B1.FL1.103-C01	Cat6A	Horizontal	Tested
12	B1.FL1.103-C02	Cat6A	Horizontal	Tested
13	B1.FL1.103-C03	Cat6A	Horizontal	Tested
14	B1.FL1.103-C04	Cat6A	Horizontal	Tested
15	B1.FL1.103-C05	Cat6A	Horizontal	Tested
16	B1.FL1.103-C06	Cat6A	Horizontal	Tested
17	B1.FL1.103-C07	Cat6A	Horizontal	Tested
18	B1.FL1.103-C08	Cat6A	Horizontal	Tested
19	B1.FL1.103-C09	Cat6A	Horizontal	Terminated
20	B1.FL1.103-C10	Cat6A	Horizontal	Terminated
21	B1.FL1.103-C11	Cat6A	Horizontal	Terminated
22	B1.FL1.103-C12	Cat6A	Horizontal	Terminated
23	—	—		—
24	—	—		—

SW01

REV B

SITE	RACK	MAKE	MODEL	PORTS	ID
Northgate Commerce Center	B1.FL1.104.RKA	Cisco	C9200-48P	48 · 44 patched · 4 empty	B1.FL1.104.SW01

01	02	03	04	05	06	07	08	09	10	11	12	13	14	15	16	17	18	19	20	21	22	23	24
25	26	27	28	29	30	31	32	33	34	35	36	37	38	39	40	41	42	43	44	45	46	47	48

PORT	DESTINATION	CABLE	FUNCTION	STATUS
01	B1.FL1.104.PP01-01	—		—
02	B1.FL1.104.PP01-02	—		—
03	B1.FL1.104.PP01-03	—		—
04	B1.FL1.104.PP01-04	—		—
05	B1.FL1.104.PP01-05	—		—
06	B1.FL1.104.PP01-06	—		—
07	B1.FL1.104.PP01-07	—		—
08	B1.FL1.104.PP01-08	—		—
09	B1.FL1.104.PP01-09	—		—
10	B1.FL1.104.PP01-10	—		—
11	B1.FL1.104.PP01-11	—		—
12	B1.FL1.104.PP01-12	—		—
13	B1.FL1.104.PP01-13	—		—
14	B1.FL1.104.PP01-14	—		—
15	B1.FL1.104.PP01-15	—		—
16	B1.FL1.104.PP01-16	—		—
17	B1.FL1.104.PP01-17	—		—
18	B1.FL1.104.PP01-18	—		—
19	B1.FL1.104.PP01-19	—		—
20	B1.FL1.104.PP01-20	—		—
21	B1.FL1.104.PP01-21	—		—
22	B1.FL1.104.PP01-22	—		—
23	B1.FL1.104.PP01-23	—		—
24	B1.FL1.104.PP01-24	—		—
25	B1.FL1.104.PP01-25	—		—
26	B1.FL1.104.PP01-26	—		—
27	B1.FL1.104.PP01-27	—		—
28	B1.FL1.104.PP01-28	—		—
29	B1.FL1.104.PP01-29	—		—
30	B1.FL1.104.PP01-30	—		—

SW01 (cont.)

REV B

SITE

Northgate Commerce Center

RACK

B1.FL1.104.RKA

PORT	DESTINATION	CABLE	FUNCTION	STATUS
31	B1.FL1.104.PP01-31	—		—
32	B1.FL1.104.PP01-32	—		—
33	B1.FL1.104.PP01-33	—		—
34	B1.FL1.104.PP01-34	—		—
35	B1.FL1.104.PP01-35	—		—
36	B1.FL1.104.PP01-36	—		—
37	B1.FL1.104.PP01-37	—		—
38	B1.FL1.104.PP01-38	—		—
39	B1.FL1.104.PP01-39	—		—
40	B1.FL1.104.PP01-40	—		—
41	B1.FL1.104.PP01-41	—		—
42	B1.FL1.104.PP01-42	—		—
43	B1.FL1.104.PP01-43	—		—
44	B1.FL1.104.PP01-44	—		—
45	—	—		—
46	—	—		—
47	—	—		—
48	—	—		—

FW01

REV B

SITE	RACK	MAKE	MODEL	PORTS	ID
Northgate Commerce Center	B1.FL1.104.RKA	Fortinet	FortiGate 100F	8 · 2 patched · 6 empty	B1.FL1.104.FW01

01

02

03

04

05

06

07

08

PORT	DESTINATION	CABLE	FUNCTION	STATUS
01	B1.FL1.104.SW01-47	—		—
02	B1.FL1.104.SW01-48	—		—
03	—	—		—
04	—	—		—
05	—	—		—
06	—	—		—
07	—	—		—
08	—	—		—

PP03

REV B

SITE	RACK	MAKE	MODEL	PORTS	ID
Northgate Commerce Center	B1.FL1.104.RKB	Leviton	49255-H24	24 · 24 tested	B1.FL1.104.PP03

01	02	03	04	05	06	07	08	09	10	11	12	13	14	15	16	17	18	19	20	21	22	23	24
----	----	----	----	----	----	----	----	----	----	----	----	----	----	----	----	----	----	----	----	----	----	----	----

PORT	DESTINATION	CABLE	FUNCTION	STATUS
01	B1.FL1.105-E01	Cat6A	Horizontal	Tested
02	B1.FL1.105-E02	Cat6A	Horizontal	Tested
03	B1.FL1.105-E03	Cat6A	Horizontal	Tested
04	B1.FL1.105-E04	Cat6A	Horizontal	Tested
05	B1.FL1.105-E05	Cat6A	Horizontal	Tested
06	B1.FL1.105-E06	Cat6A	Horizontal	Tested
07	B1.FL1.105-E07	Cat6A	Horizontal	Tested
08	B1.FL1.105-E08	Cat6A	Horizontal	Tested
09	B1.FL1.105-E09	Cat6A	Horizontal	Tested
10	B1.FL1.105-E10	Cat6A	Horizontal	Tested
11	B1.FL1.105-E11	Cat6A	Horizontal	Tested
12	B1.FL1.105-E12	Cat6A	Horizontal	Tested
13	B1.FL1.105-E13	Cat6A	Horizontal	Tested
14	B1.FL1.105-E14	Cat6A	Horizontal	Tested
15	B1.FL1.105-E15	Cat6A	Horizontal	Tested
16	B1.FL1.105-E16	Cat6A	Horizontal	Tested
17	B1.FL1.105-E17	Cat6A	Horizontal	Tested
18	B1.FL1.105-E18	Cat6A	Horizontal	Tested
19	B1.FL1.105-E19	Cat6A	Horizontal	Tested
20	B1.FL1.105-E20	Cat6A	Horizontal	Tested
21	B1.FL1.105-E21	Cat6A	Horizontal	Tested
22	B1.FL1.105-E22	Cat6A	Horizontal	Tested
23	B1.FL1.105-E23	Cat6A	Horizontal	Tested
24	B1.FL1.105-E24	Cat6A	Horizontal	Tested

SITE	RACK	MAKE	MODEL	PORTS	ID
Northgate Commerce Center	B1.FL1.104.RKB	Leviton	49255-H24	24 · 20 tested · 4 terminated	B1.FL1.104.PP04

01	02	03	04	05	06	07	08	09	10	11	12	13	14	15	16	17	18	19	20	21	22	23	24
----	----	----	----	----	----	----	----	----	----	----	----	----	----	----	----	----	----	----	----	----	----	----	----

PORT	DESTINATION	CABLE	FUNCTION	STATUS
01	B1.FL1.106-F01	Cat6A	Horizontal	Tested
02	B1.FL1.106-F02	Cat6A	Horizontal	Tested
03	B1.FL1.106-F03	Cat6A	Horizontal	Tested
04	B1.FL1.106-F04	Cat6A	Horizontal	Tested
05	B1.FL1.106-F05	Cat6A	Horizontal	Tested
06	B1.FL1.106-F06	Cat6A	Horizontal	Tested
07	B1.FL1.106-F07	Cat6A	Horizontal	Tested
08	B1.FL1.106-F08	Cat6A	Horizontal	Tested
09	B1.FL1.106-F09	Cat6A	Horizontal	Tested
10	B1.FL1.106-F10	Cat6A	Horizontal	Tested
11	B1.FL1.106-F11	Cat6A	Horizontal	Tested
12	B1.FL1.106-F12	Cat6A	Horizontal	Tested
13	B1.FL1.106-F13	Cat6A	Horizontal	Tested
14	B1.FL1.106-F14	Cat6A	Horizontal	Tested
15	B1.FL1.106-F15	Cat6A	Horizontal	Tested
16	B1.FL1.106-F16	Cat6A	Horizontal	Tested
17	B1.FL1.106-F17	Cat6A	Horizontal	Terminated
18	B1.FL1.106-F18	Cat6A	Horizontal	Terminated
19	B1.FL1.106-F19	Cat6A	Horizontal	Terminated
20	B1.FL1.106-F20	Cat6A	Horizontal	Terminated
21	B1.FL1.104-D01	Cat6A	Horizontal	Tested
22	B1.FL1.104-D02	Cat6A	Horizontal	Tested
23	B1.FL1.104-D03	Cat6A	Horizontal	Tested
24	B1.FL1.104-D04	Cat6A	Horizontal	Tested

PP05

REV B

SITE	RACK	MAKE	MODEL	PORTS	ID
Northgate Commerce Center	B1.FL2.204.RKC	Panduit	DP48688TGY	48 · 30 tested · 13 terminated · 4 empty · 1 fault	B1.FL2.204.PP05

01	02	03	04	05	06	07	08	09	10	11	12	13	14	15	16	17	18	19	20	21	22	23	24
25	26	27	28	29	30	31	32	33	34	35	36	37	38	39	40	41	42	43	44	45	46	47	48

PORT	DESTINATION	CABLE	FUNCTION	STATUS
01	B1.FL2.201-G01	Cat6A	Horizontal	Tested
02	B1.FL2.201-G02	Cat6A	Horizontal	Tested
03	B1.FL2.201-G03	Cat6A	Horizontal	Tested
04	B1.FL2.201-G04	Cat6A	Horizontal	Tested
05	B1.FL2.201-G05	Cat6A	Horizontal	Tested
06	B1.FL2.201-G06	Cat6A	Horizontal	Tested
07	B1.FL2.201-G07	Cat6A	Horizontal	Tested
08	B1.FL2.201-G08	Cat6A	Horizontal	Tested
09	B1.FL2.201-G09	Cat6A	Horizontal	Tested
10	B1.FL2.201-G10	Cat6A	Horizontal	Tested
11	B1.FL2.201-G11	Cat6A	Horizontal	Tested
12	B1.FL2.201-G12	Cat6A	Horizontal	Tested
13	B1.FL2.201-G13	Cat6A	Horizontal	Tested
14	B1.FL2.201-G14	Cat6A	Horizontal	Tested
15	B1.FL2.201-G15	Cat6A	Horizontal	Tested
16	B1.FL2.201-G16	Cat6A	Horizontal	Tested
17	B1.FL2.201-G17	Cat6A	Horizontal	Tested
18	B1.FL2.201-G18	Cat6A	Horizontal	Tested
19	B1.FL2.201-G19	Cat6A	Horizontal	Tested
20	B1.FL2.201-G20	Cat6A	Horizontal	Tested
21	B1.FL2.201-G21	Cat6A	Horizontal	Tested
22	B1.FL2.201-G22	Cat6A	Horizontal	Tested
23	B1.FL2.201-G23	Cat6A	Horizontal	Tested
24	B1.FL2.201-G24	Cat6A	Horizontal	Tested
25	B1.FL2.201-G25	Cat6A	Horizontal	Tested
26	B1.FL2.201-G26	Cat6A	Horizontal	Tested
27	B1.FL2.201-G27	Cat6A	Horizontal	Tested
28	B1.FL2.201-G28	Cat6A	Horizontal	Tested
29	B1.FL2.201-G29	Cat6A	Horizontal	Tested
30	B1.FL2.201-G30	Cat6A	Horizontal	Tested

PP05 (cont.)

REV B

SITE
Northgate Commerce Center

RACK
B1.FL2.204.RKC

PORT	DESTINATION	CABLE	FUNCTION	STATUS
31	B1.FL2.201-G31	Cat6A	Horizontal	Terminated
32	B1.FL2.201-G32	Cat6A	Horizontal	Terminated
33	B1.FL2.201-G33	Cat6A	Horizontal	Terminated
34	B1.FL2.201-G34	Cat6A	Horizontal	Terminated
35	B1.FL2.201-G35	Cat6A	Horizontal	Terminated
36	B1.FL2.201-G36	Cat6A	Horizontal	Terminated
37	B1.FL2.201-G37	Cat6A	Horizontal	Terminated
38	B1.FL2.201-G38	Cat6A	Horizontal	Terminated
39	B1.FL2.201-G39	Cat6A	Horizontal	Terminated
40	B1.FL2.201-G40	Cat6A	Horizontal	Fault
41	B1.FL2.201-G41	Cat6A	Horizontal	Terminated
42	B1.FL2.201-G42	Cat6A	Horizontal	Terminated
43	B1.FL2.201-G43	Cat6A	Horizontal	Terminated
44	B1.FL2.201-G44	Cat6A	Horizontal	Terminated
45	—	—		—
46	—	—		—
47	—	—		—
48	—	—		—

PP06

REV B

SITE	RACK	MAKE	MODEL	PORTS	ID
Northgate Commerce Center	B1.FL2.204.RKC	Leviton	49255-H24	24 · 24 tested	B1.FL2.204.PP06

01	02	03	04	05	06	07	08	09	10	11	12	13	14	15	16	17	18	19	20	21	22	23	24
----	----	----	----	----	----	----	----	----	----	----	----	----	----	----	----	----	----	----	----	----	----	----	----

PORT	DESTINATION	CABLE	FUNCTION	STATUS
01	B1.FL2.202-J01	Cat6A	Horizontal	Tested
02	B1.FL2.202-J02	Cat6A	Horizontal	Tested
03	B1.FL2.202-J03	Cat6A	Horizontal	Tested
04	B1.FL2.202-J04	Cat6A	Horizontal	Tested
05	B1.FL2.202-J05	Cat6A	Horizontal	Tested
06	B1.FL2.202-J06	Cat6A	Horizontal	Tested
07	B1.FL2.202-J07	Cat6A	Horizontal	Tested
08	B1.FL2.202-J08	Cat6A	Horizontal	Tested
09	B1.FL2.202-J09	Cat6A	Horizontal	Tested
10	B1.FL2.202-J10	Cat6A	Horizontal	Tested
11	B1.FL2.202-J11	Cat6A	Horizontal	Tested
12	B1.FL2.202-J12	Cat6A	Horizontal	Tested
13	B1.FL2.202-J13	Cat6A	Horizontal	Tested
14	B1.FL2.202-J14	Cat6A	Horizontal	Tested
15	B1.FL2.202-J15	Cat6A	Horizontal	Tested
16	B1.FL2.202-J16	Cat6A	Horizontal	Tested
17	B1.FL2.202-J17	Cat6A	Horizontal	Tested
18	B1.FL2.202-J18	Cat6A	Horizontal	Tested
19	B1.FL2.202-J19	Cat6A	Horizontal	Tested
20	B1.FL2.202-J20	Cat6A	Horizontal	Tested
21	B1.FL2.204-H01	Cat6A	Horizontal	Tested
22	B1.FL2.204-H02	Cat6A	Horizontal	Tested
23	B1.FL2.204-H03	Cat6A	Horizontal	Tested
24	B1.FL2.204-H04	Cat6A	Horizontal	Tested